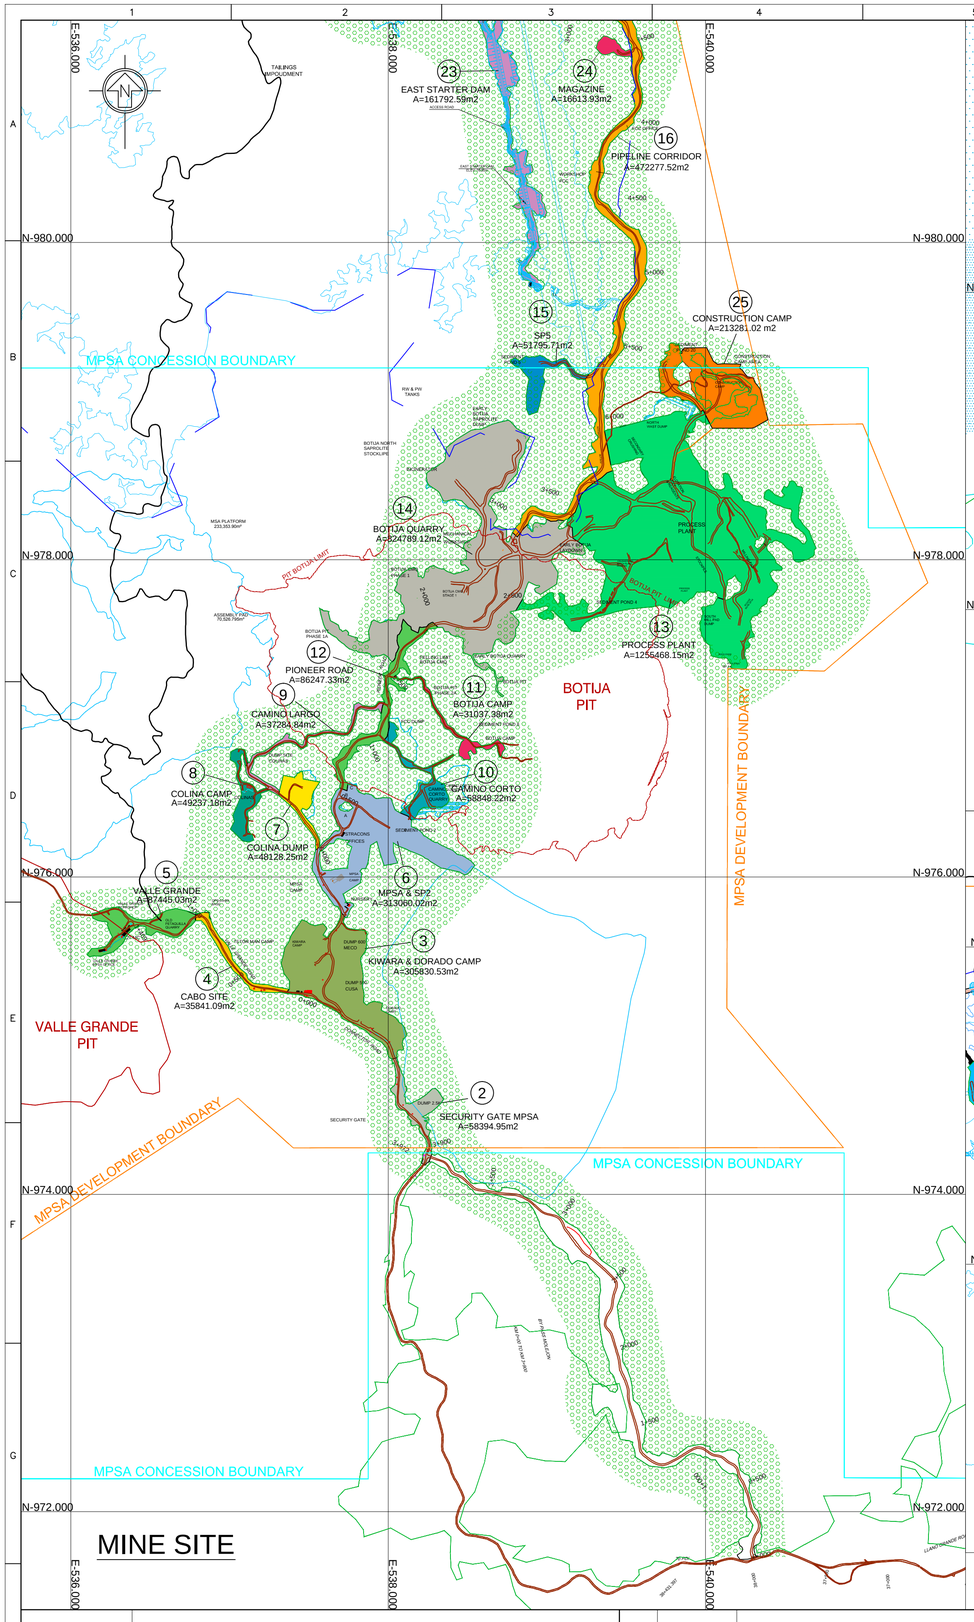

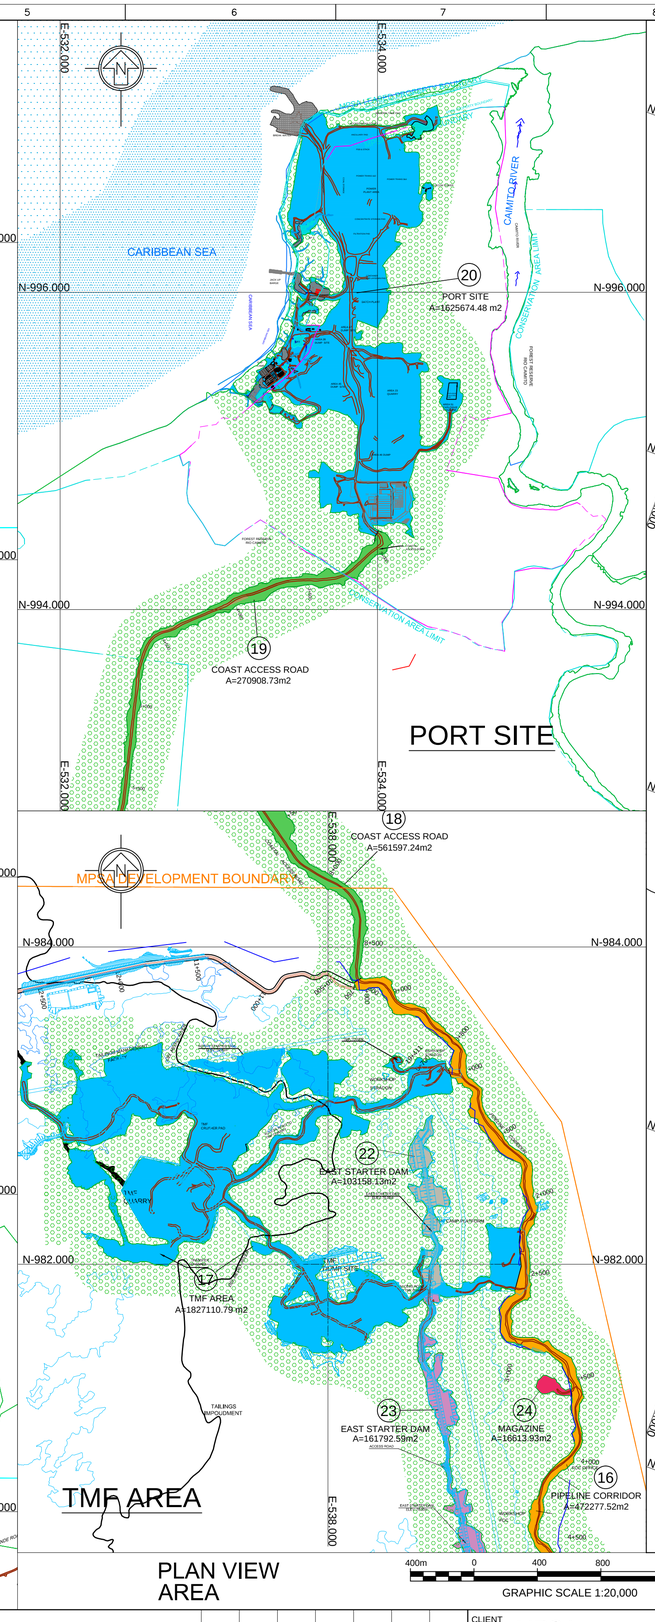

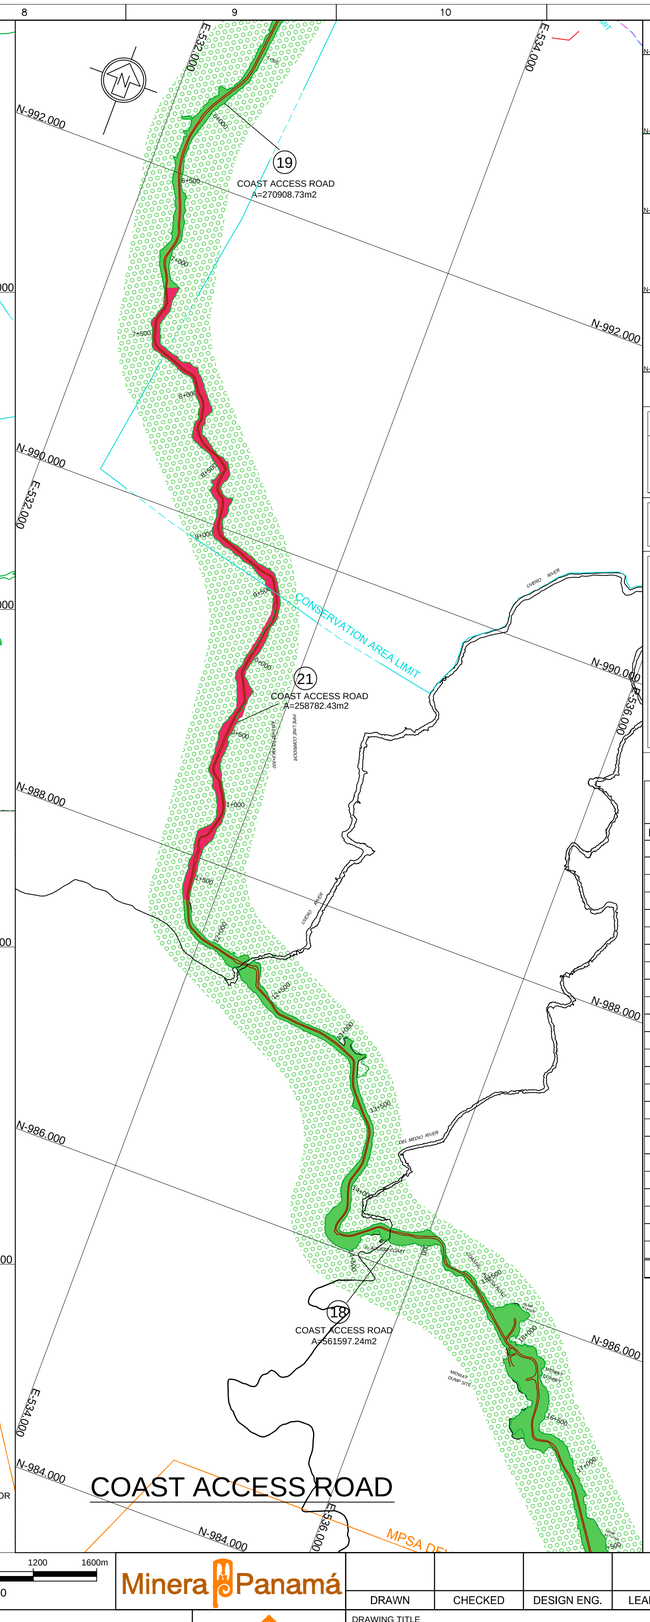

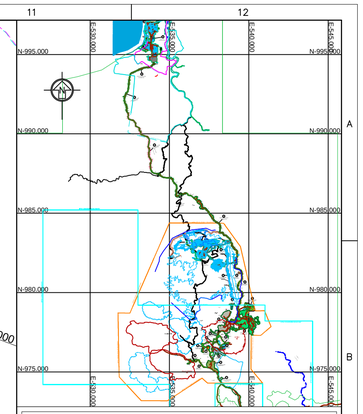

AUXILIARY CONTROL POINT

LEGEND

- ROAD
- POLYGON OF FOREST CLEARED
- POLYGON OF INFLUENCE OF WORKS
- MPSA CONCESSION BOUNDARY
- CONSERVATION AREA LIMIT

TABLE
POLYGON OF FOREST CLEARED

POLYGON	SITE	AREA
2	SECURITY GATE MPSA	5 Hect +8394.95 m2
3	KIWARA & DORADO CAMP	30 Hect +5830.53 m2
4	CABO SITE	3 Hect +5841.09 m2
5	VALLE GRANDE	8 Hect +7445.03 m2
6	MPSA & SP2	31 Hect +3060.02 m2
7	COLINA DUMP	4 Hect +8128.25 m2
8	COLINA CAMP	4 Hect +9237.18 m2
9	CAMINO LARGO	3 Hect +7284.84 m2
10	CAMINO CORTO	5 Hect +8848.22 m2
11	BOTIJA CAMP	3 Hect +1037.38 m2
12	PIONEER ROAD	8 Hect +6247.33 m2
13	PROCESS PLANT	125 Hect +5468.15 m2
14	BOTIJA QUARRY	82 Hect +4789.12 m2
15	SP5	5 Hect +1795.71 m2
16	PIPELINE CORRIDOR	47 Hect +2277.52 m2
17	TMF AREA	182 Hect +7110.79 m2
18	COAST ACCESS ROAD	56 Hect +1597.24 m2
19	COAST ACCESS ROAD	27 Hect +0908.73 m2
20	PORT SITE	162 Hect +5674.48 m2
21	COAST ACCESS ROAD	25 Hect +8782.43 m2
22	EAST STARTER DAM	10 Hect +3158.13 m2
23	EAST STARTER DAM	16 Hect +1792.59 m2
24	MAGAZINE	1 Hect +6613.93 m2
25	CONSTRUCTION CAMP	21 Hect +3281.02 m2
	TOTAL	**875 Hect +4604.66 m2**

NOTES:
1. ALL DIMENSIONS, ELEVATIONS AND GRID COORDINATES SHOWN ON THIS DRAWING ARE IN METERS. GRID SHOWN IS REFERENCED TO UTM WGS84 ZONE 17N DATUM.

PLAN VIEW AREA

400m 0 400 800 1200 1600m

GRAPHIC SCALE 1:20,000

Minera Panamá

DRAWN	CHECKED	DESIGN ENG.	LEAD ENG.	DESIGN APP'D	PROJ. APP'D	CLIENT APP'D

DRG No	REFERENCE DRAWINGS	REV	DATE	DESCRIPTION	DRN	CHK'D	DESIGN ENG.	LEAD ENG.	DESIGN APP'D	PROJ. APP'D	CLIENT APP'D
		00	29 / OCT / 2014	ASBUILT PLAN - POLYGON OF FOREST CLEARED	JP	AM					
		00	30 / SEP / 2014	ASBUILT PLAN - POLYGON OF FOREST CLEARED	JP						

CLIENT: MPSA

PROJECT: MINA DE COBRE PANAMA

FIRST QUANTUM MINERALS LTD.

DRAWING TITLE: COBRE PANAMA PROJECT
FOREST CLEARED AREAS

GENERAL PLAN

THIS DRAWING IS THE PROPERTY OF MINERA PANAMA S.A (MPSA), AND THE USE AND COPYING THEREOF IS SUBJECT TO THE TERMS OF THE AGREEMENT UNDER WHICH IT WAS PREPARED. THIS DRAWING MAY NOT BE COPIED EXCEPT AS EXPRESSLY PROVIDED THEREIN.

ESTE PLANO ES PROPIEDAD DE MINERA PANAMA S.A (MPSA), SU USO Y REPRODUCCION ESTAN SUJETOS A LOS TERMINOS DEL CONTRATO BAJO EL CUAL FUE PREPARADO. PROHIBIDA SU REPRODUCCION A MENOS QUE SEA EXPRESAMENTE INDICADO.

SCALE	JOB No.	DRG No.	REV.
1:20,000	1824		01

DRAWN	DATE
JOSE PEÑALOZA	29 OCT 2014

Format A1